
AS-BUILT SKETCH AND STATEMENT OF ACCURACY OF INSTALLATION

Landowner's name Mattfeldt, George + Fern
Permit number 20 - 12 2
as the licensed installer or landowner for the following system have constructed or altered the septic system on the parcel referenced by the permit number above.
I do hereby declare that the EXACT specifications of the approved permit have been followed. Accompanying this statement is a copy of the county approved lot layout and my as-built sketch. My asbuilt sketch is included on another sheet of paper. I understand that it is my responsibility
to submit the above within 30 days of the completion of the system.
INSTALLER'S SIGNATURE
INSTALLER'S LICENSE NUMBER SE 21
COMPLETION DATE OF SYSTEM 7/29/2020
Checklist of as-built sketch:
North Arrow Triangular measurements from two corners of house to tank access lid. Measurement of pipe from tank to D-box or Manifold All parcel boundaries Distance between the system and at least two parcel boundaries
Additional information needed (fill the blanks in with quantitative data):
<u>So</u> Length of drainfield laterals
Pipe & Gravel
<u></u> ✓ Infiltrators
${\cal Q}$ Number of drainfield laterals
/5 <u>00</u> Volume of septic tank
Copy of Pump Specs if Pressurized

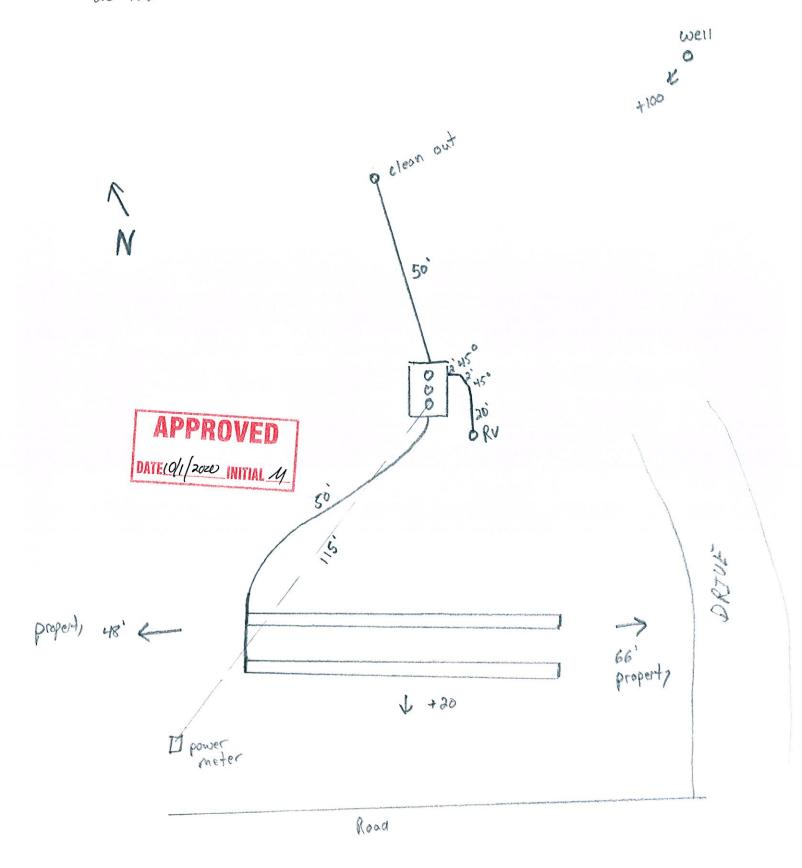

PERMIT APPROVAL SPECIFICATIONS

Sanders County Environmental Health Department 1111 Main St. Thompson Falls, MT, 59873 * 406.827.6909



Owner information:

George L. and Fern Mattfeldt	<u>24 26N 33W</u>	
Name	S T R	
67 Fern Acres Lane	05/29/2020	_
Mailing address	Date Submitted	
Superior, MT 59872	06/11/2020	
City	Date Approved	
20-122	06/11/2022	
Permit Number	Expiration Date	
14 Bartholomew Road, Noxon		
Physical Address		

This permit is approved with the following specifications:

Installation of a pressure-dosed, sand-lined wastewater treatment system for a two (2) bedroom living unit, and an RV dump station for occupants of the living unit.

- 1500-gallon combination septic and dosing tank with effluent filter
- 2.0-inch schedule 40 PVC transport line
- 2.0-inch schedule 40 PVC manifold
- 1.50-inch schedule 40 PVC laterals, with 3/16-inch orifices spaced 4 feet apart with 2.0-feet lead-in from the ends
- Trenches must be gravelless chambers and sand-lined
- Pump capable of 38 GPM @ 22 feet TDH, installer must verify with distributor

Gravelless Chambers:

Sand-lined in accordance with pages 71-72 of Circular DEQ 4, 2013 edition.

Pressure dosed trenches are 3 feet wide and a maximum depth of 36 inches.
*Gravelless chamber calculations are based on 3-foot by 5-foot chamber sections.
Follow all Sanders County wastewater regulations & State regulations outlined in Circular DEQ 4, 2013 edition. Install the system as approved on the Lot Layout.

Pre-notification is mandatory 48 hours before backfilling system.

Sanders County Sanitarian